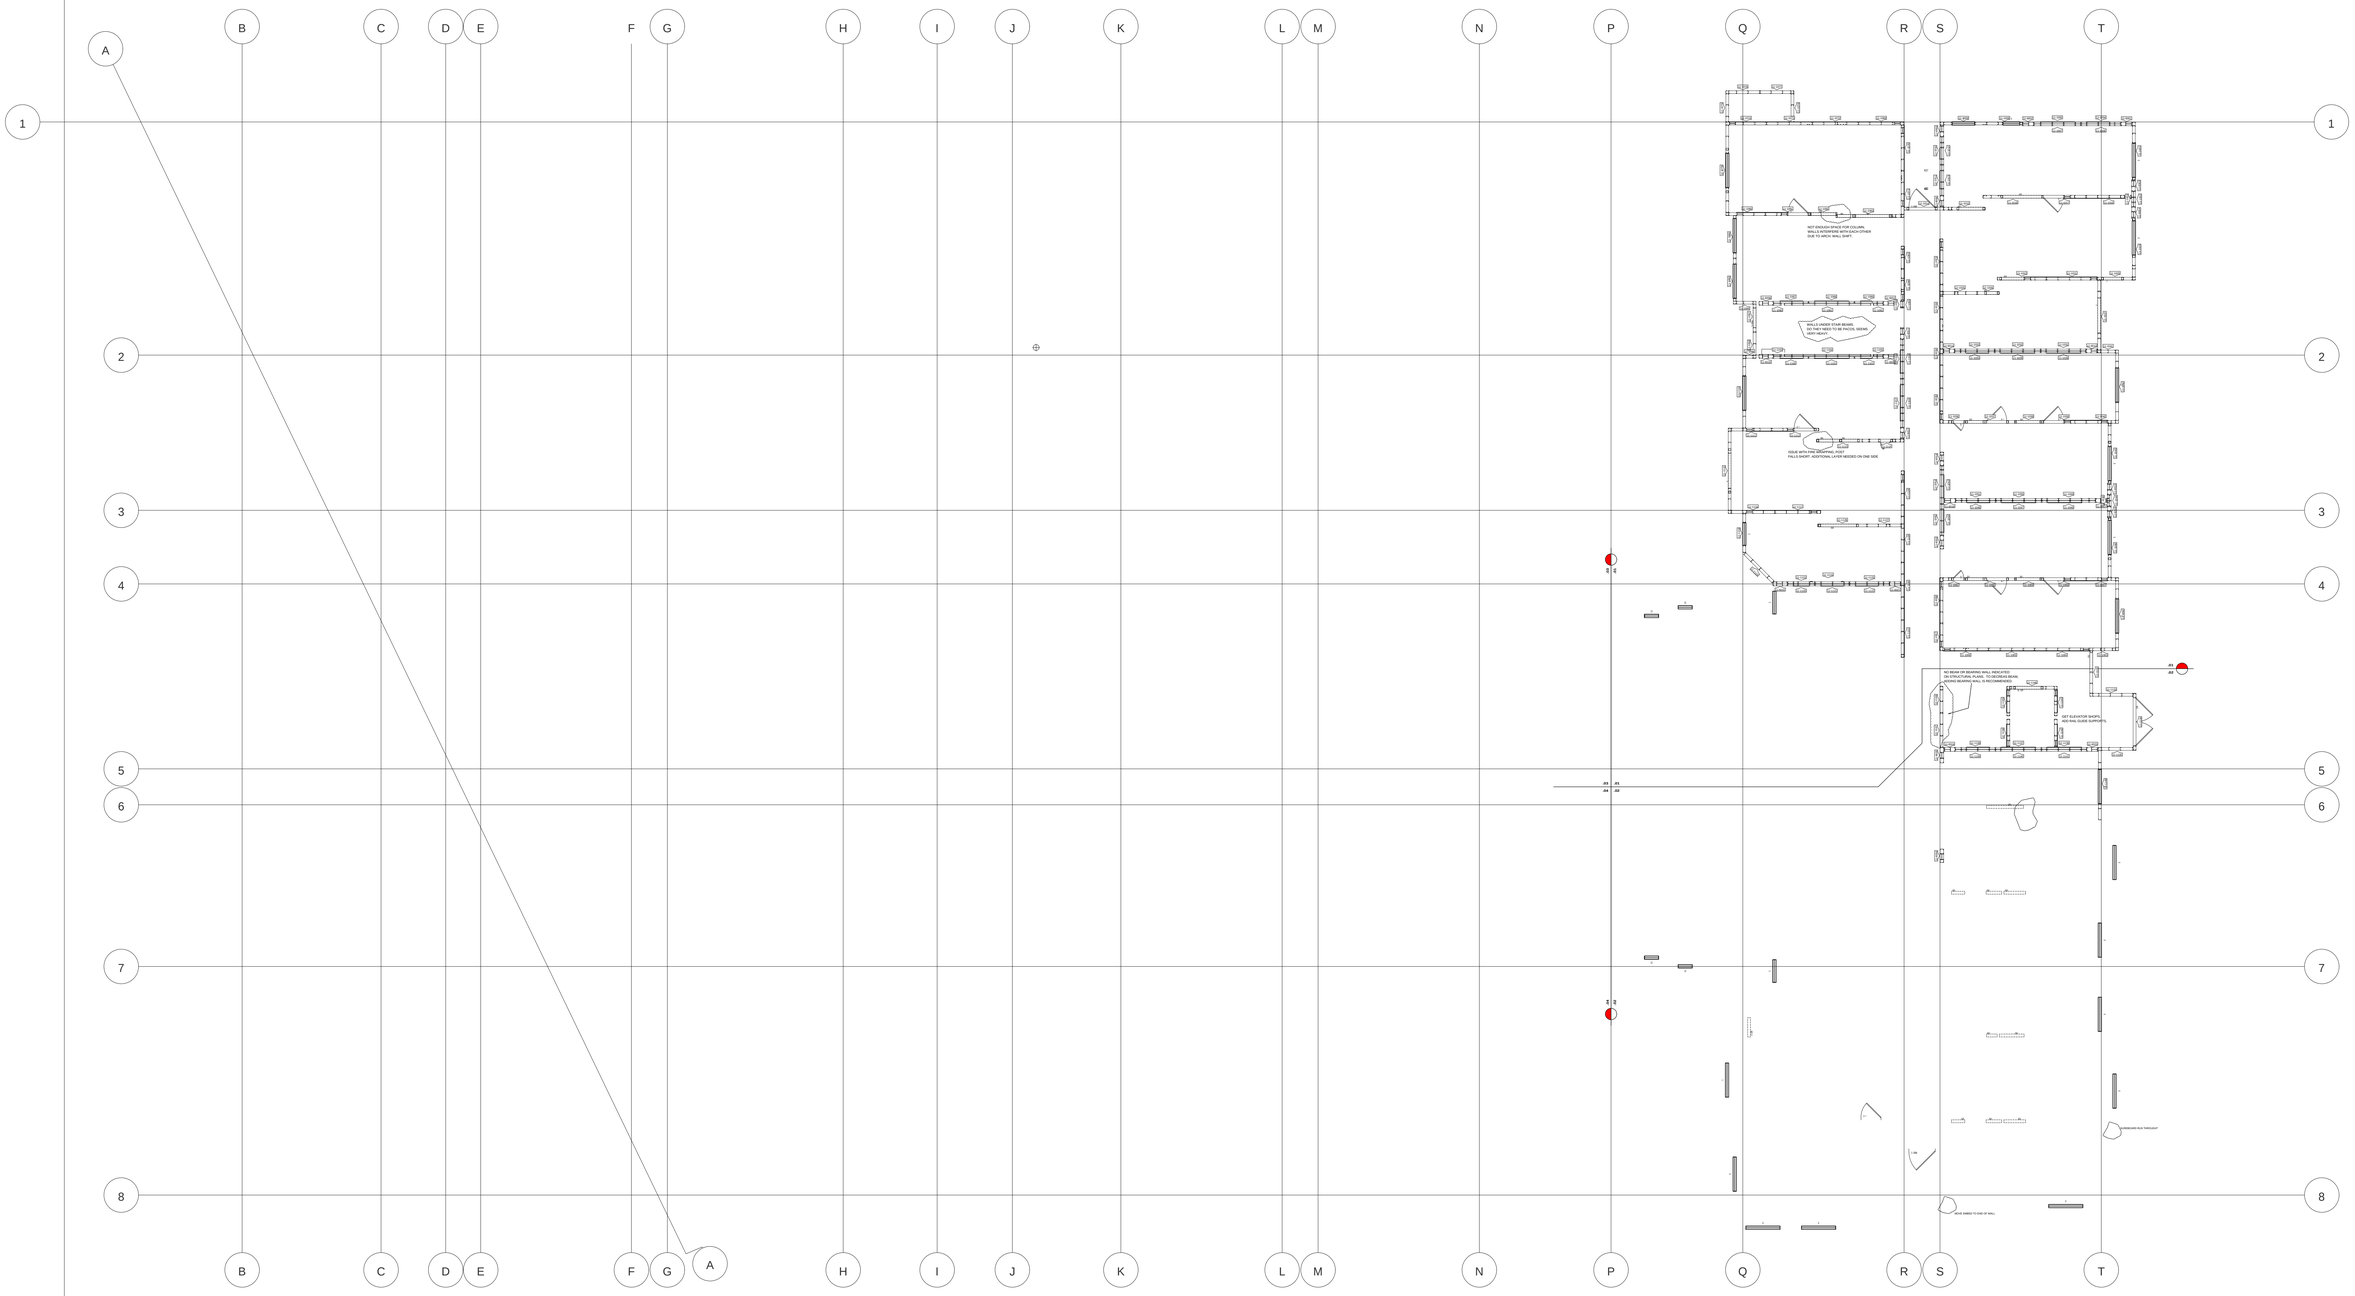

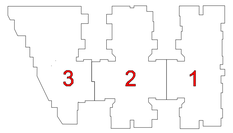

REV.	DATE	DESCRIPTION
1	9/12	Initial
-	-	-
-	-	-
-	-	-
-	-	-
-	-	-
-	-	-
-	-	-
-	-	-
-	-	-
-	-	-

DRAWING STATUS	DATE
[ ] SUBMITTAL	-
[ ] REDLINE COMPLETION	-
[ ] APPROVED	-
[X] ISSUED FOR FABRICATION	9/12/08

DRAWING TITLE

Wall Panel Layout Overall

Jewish Home for the Aging

1885 Victory Blvd.
Reseda, CA

BUILDING NAME
Jewish Home for the Aging

PROJECT
FM-07-109, JHA

Frame Max, Inc.
Poway, CA 92064
P: 858.486.7223
F: 858.486.7220
www.framemax.com

FRAMEMAX

PROJECT NO.:
FM-07-109

DRAWING NO.:
1.2.0

PLOT DATE: 09/12/2008

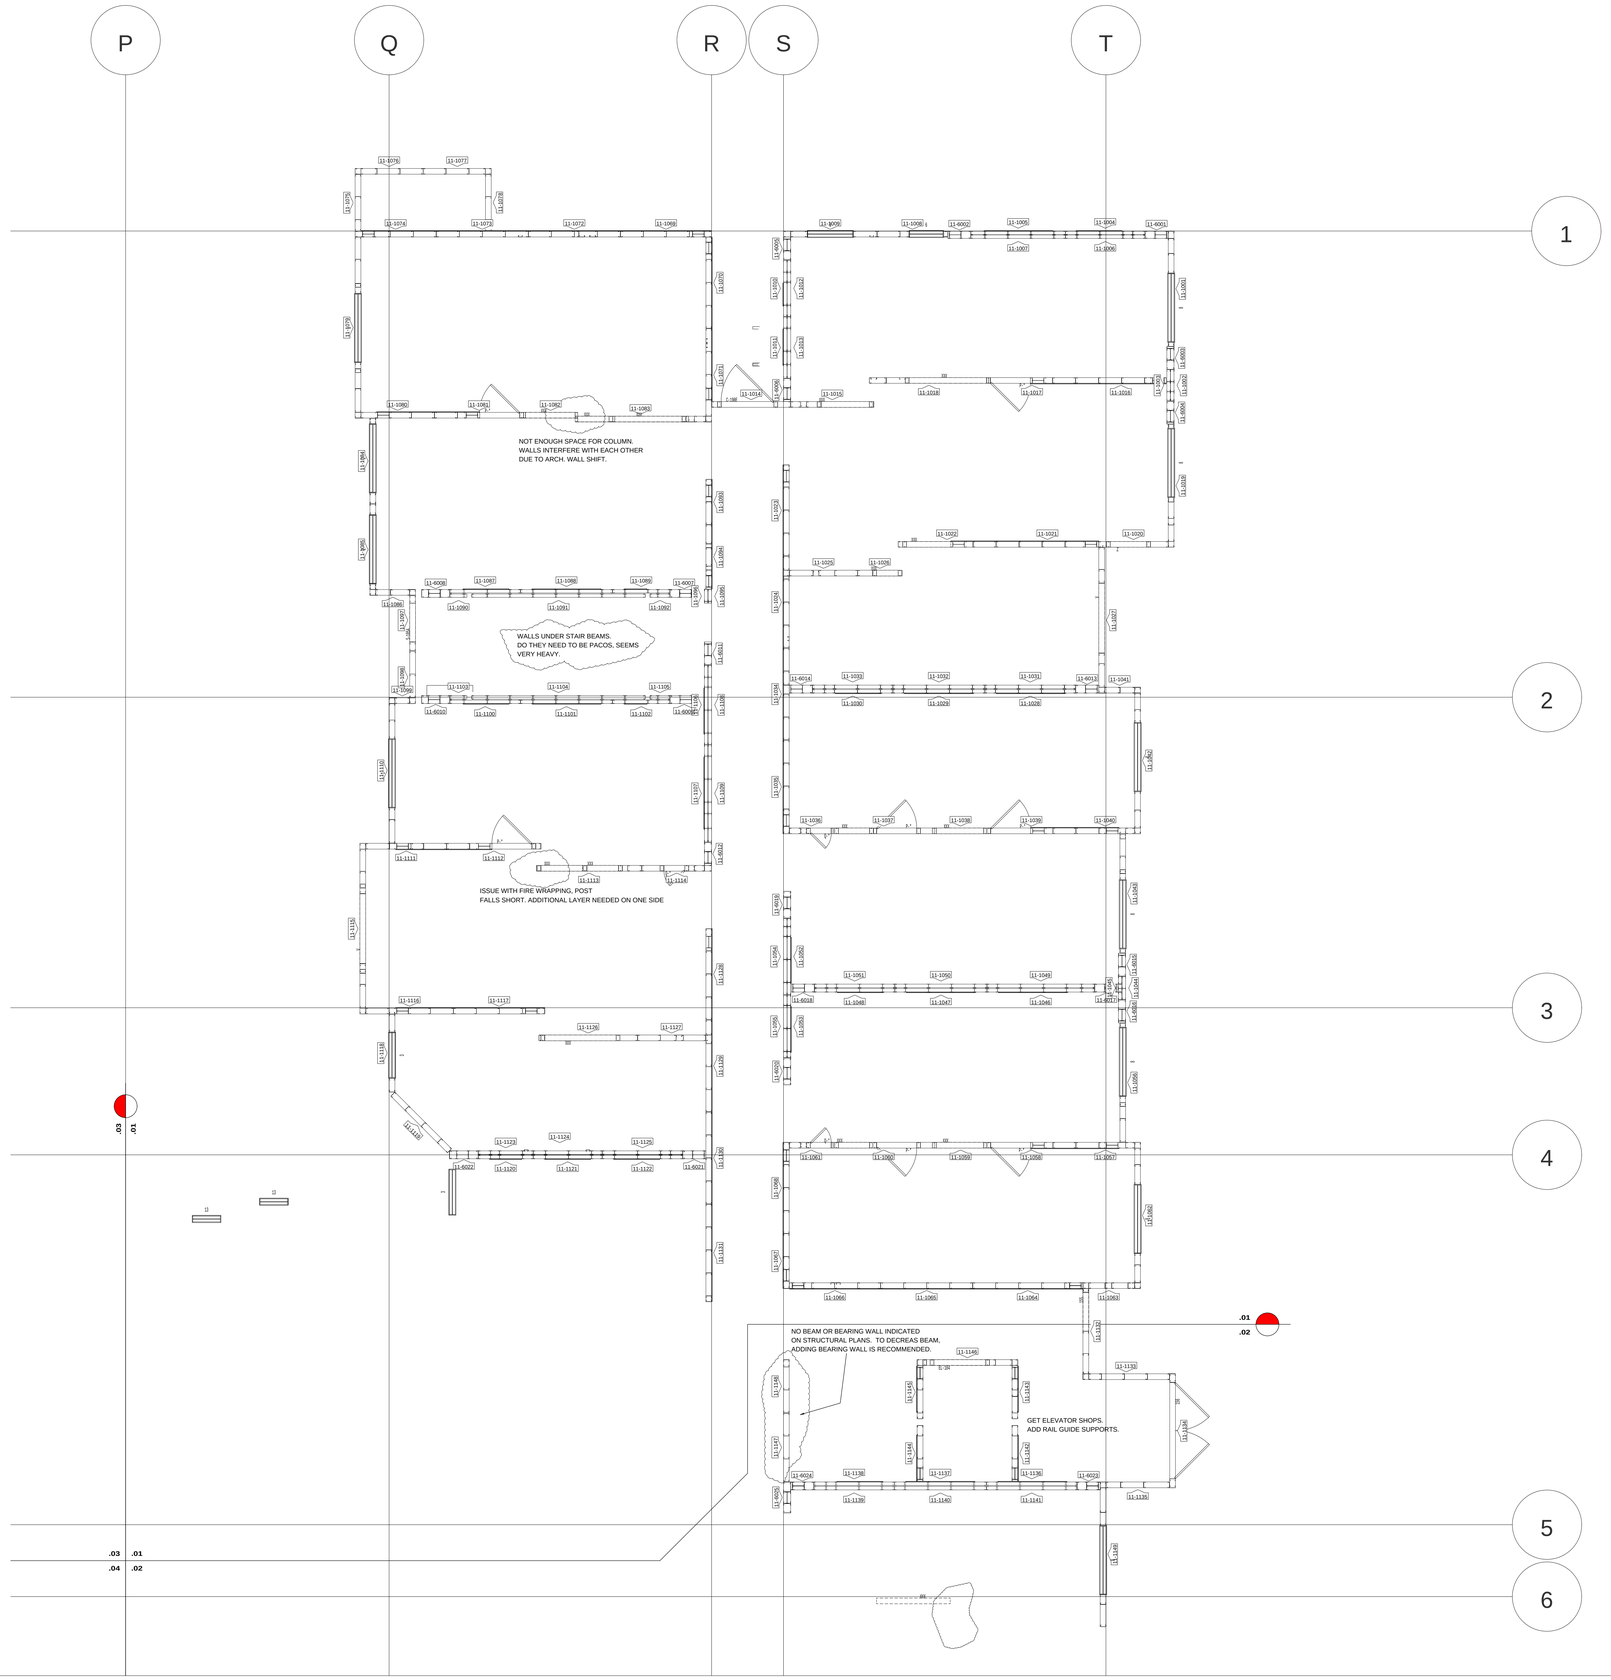

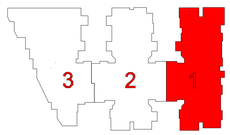

REV.	DATE	DESCRIPTION
1	9/12	Initial
-	-	-
-	-	-
-	-	-
-	-	-
-	-	-
-	-	-
-	-	-
-	-	-
-	-	-
-	-	-

DRAWING STATUS	DATE
SUBMITTAL	-
REDLINE COMPLETION	-
APPROVED	-
X ISSUED FOR FABRICATION	9/12/08

Wall Panel Layout (Segment 1a)

Jewish Home for the Aging

1885 Victory Blvd.
Reseda, CA

DRAWING TITLE

BUILDING NAME: Jewish Home for the Aging
PROJECT NAME: PROJ#: 109, JHA

Framemax, Inc.
Poway, CA 92064
T: 858-486-7020
F: 858-486-7220
www.framemax.com

FRAMEMAX

PROJECT NO.:
FM-07-109

DRAWING NO.:
1.2.1

PLOT DATE: 09/12/2008

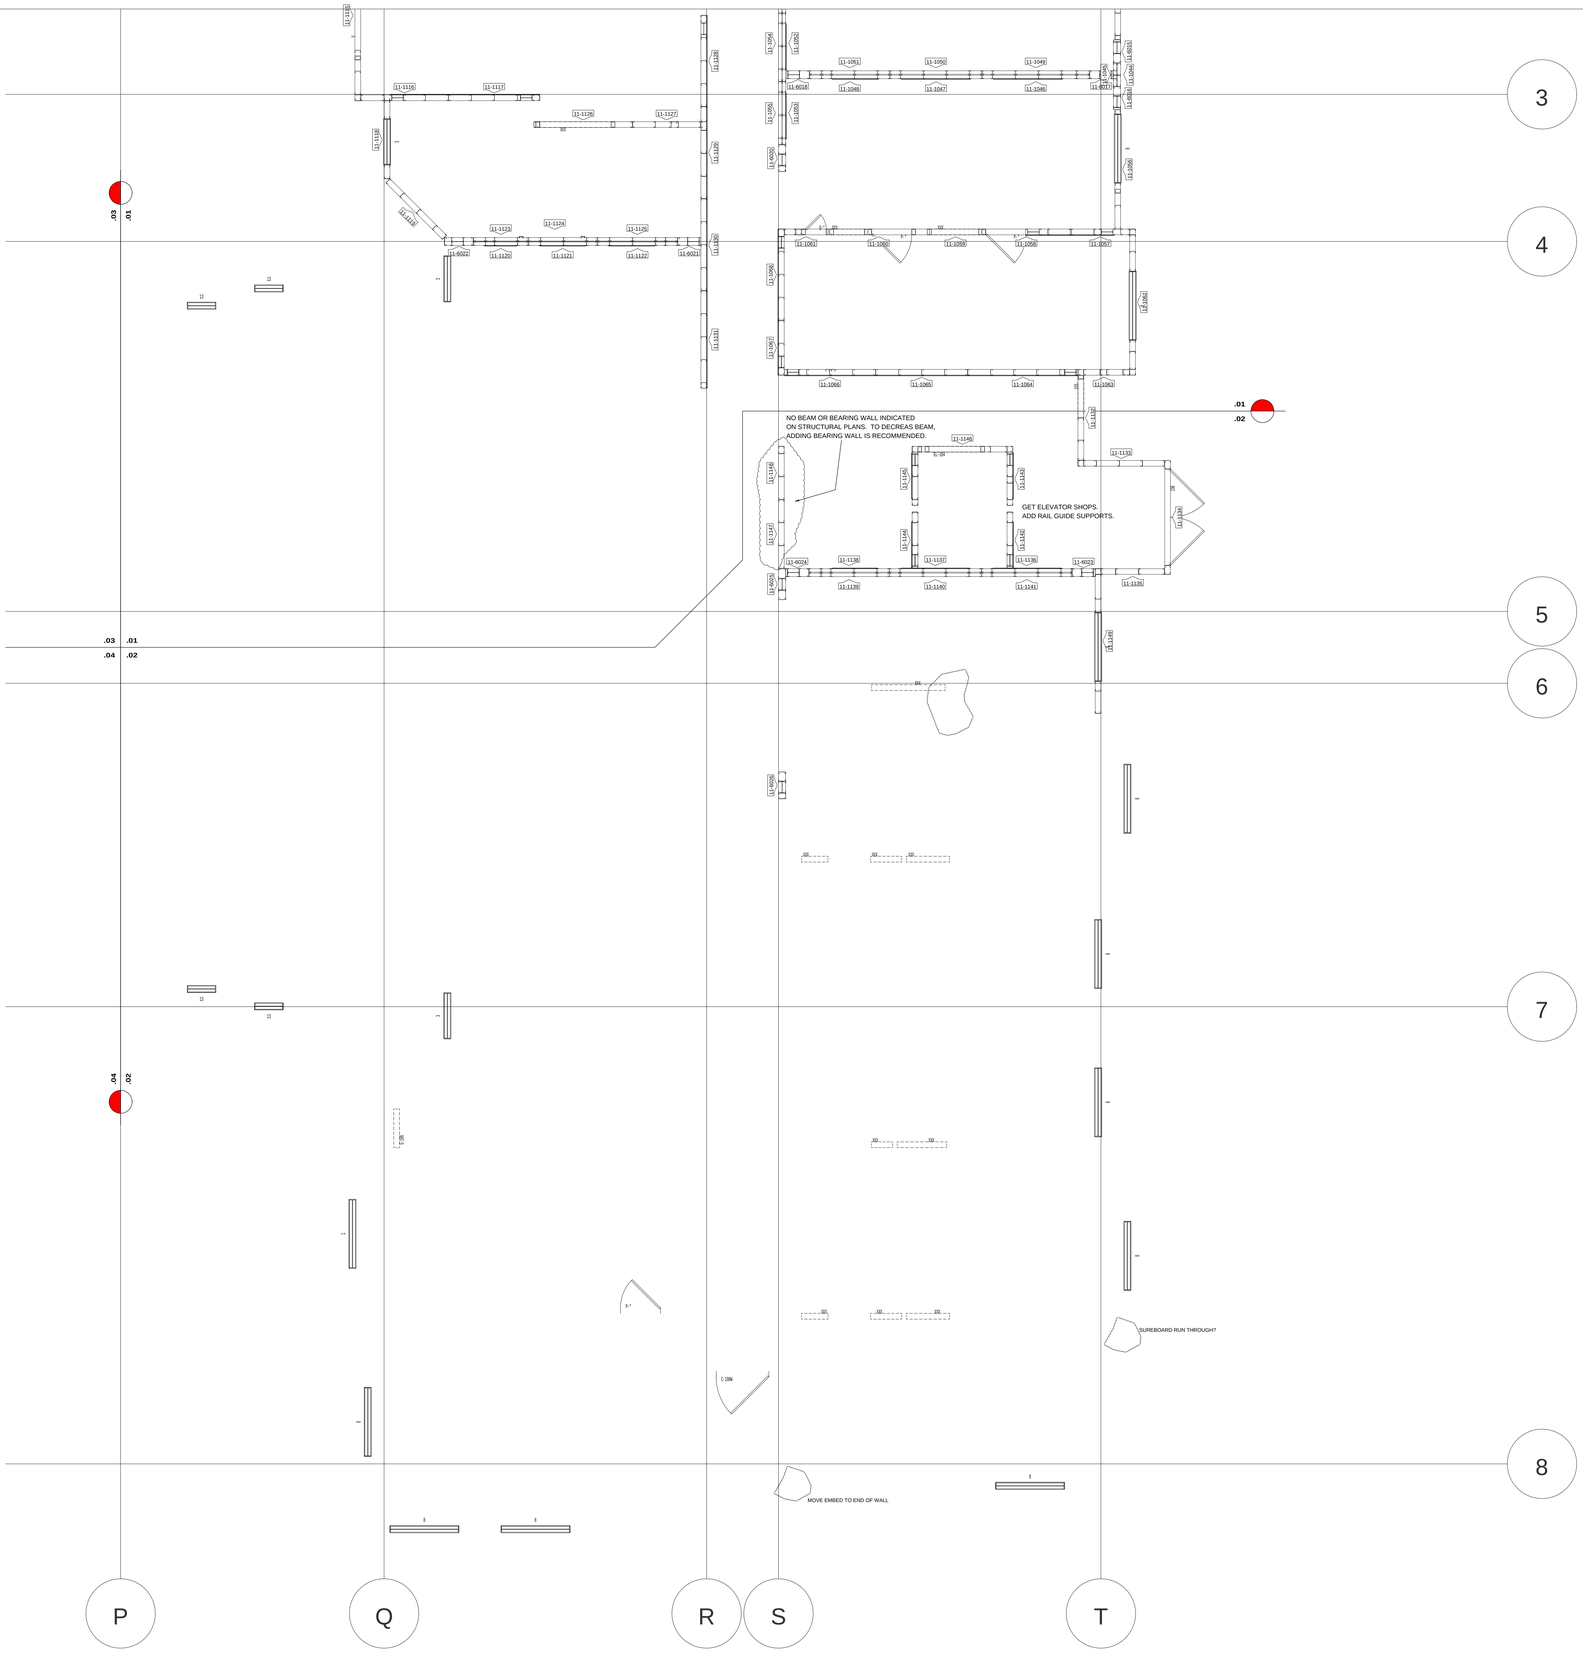

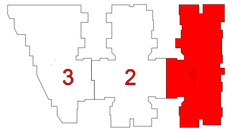

REV.	DATE	DESCRIPTION
1	9/12	Initial
.	.	.
.	.	.
.	.	.
.	.	.
.	.	.
.	.	.
.	.	.
.	.	.
.	.	.

DRAWING STATUS	DATE
SUBMITTAL	.
REDLINE COMPLETION	.
APPROVED	.
[X] ISSUED FOR FABRICATION	9/12/08

DRAWING TITLE

Wall Panel Layout (Segment 1b)

Jewish Home for the Aging

1885 Victory Blvd.
Reseda, CA

BUILDING NAME

Jewish Home for the Aging

PROJECT NO.

FM-07-109, JHA

Framemax, Inc.
13915 Danielson St. S 100
Poway, CA. 92064
P: 858-486-7220
F: 858-486-7223
www.framemax.com

FRAMEMAX

PROJECT NO.:

FM-07-109

DRAWING NO.:

1.2.2

PLOT DATE: 09/12/2008