REV	DATE	DESCRIPTION
1	9/12	Initial

DRAWING STATUS — DATE
- PRELIMINARY
- PRELIMINARY COMPLETION
- APPROVED
- ISSUED FOR FABRICATION — 9/12/08

Jewish Home for the Aging

1885 Victory Blvd.
Reseda, CA

Wall Panel Layout Overall

DRAWING TITLE

RAMEMAX
BUILDING NAME
Jewish Home for the Aging
PROJECT
FM-07-109, JHA
Framemax, Inc.
13915 Dalewalton St. S 103
Poway, CA 92064
T: 858.486.7200
F: 858.486.7220
www.framemax.com

PROJECT NO.: FM-07-109

DRAWING NO.: **1.2.0**

PLOT DATE: 09/09/08

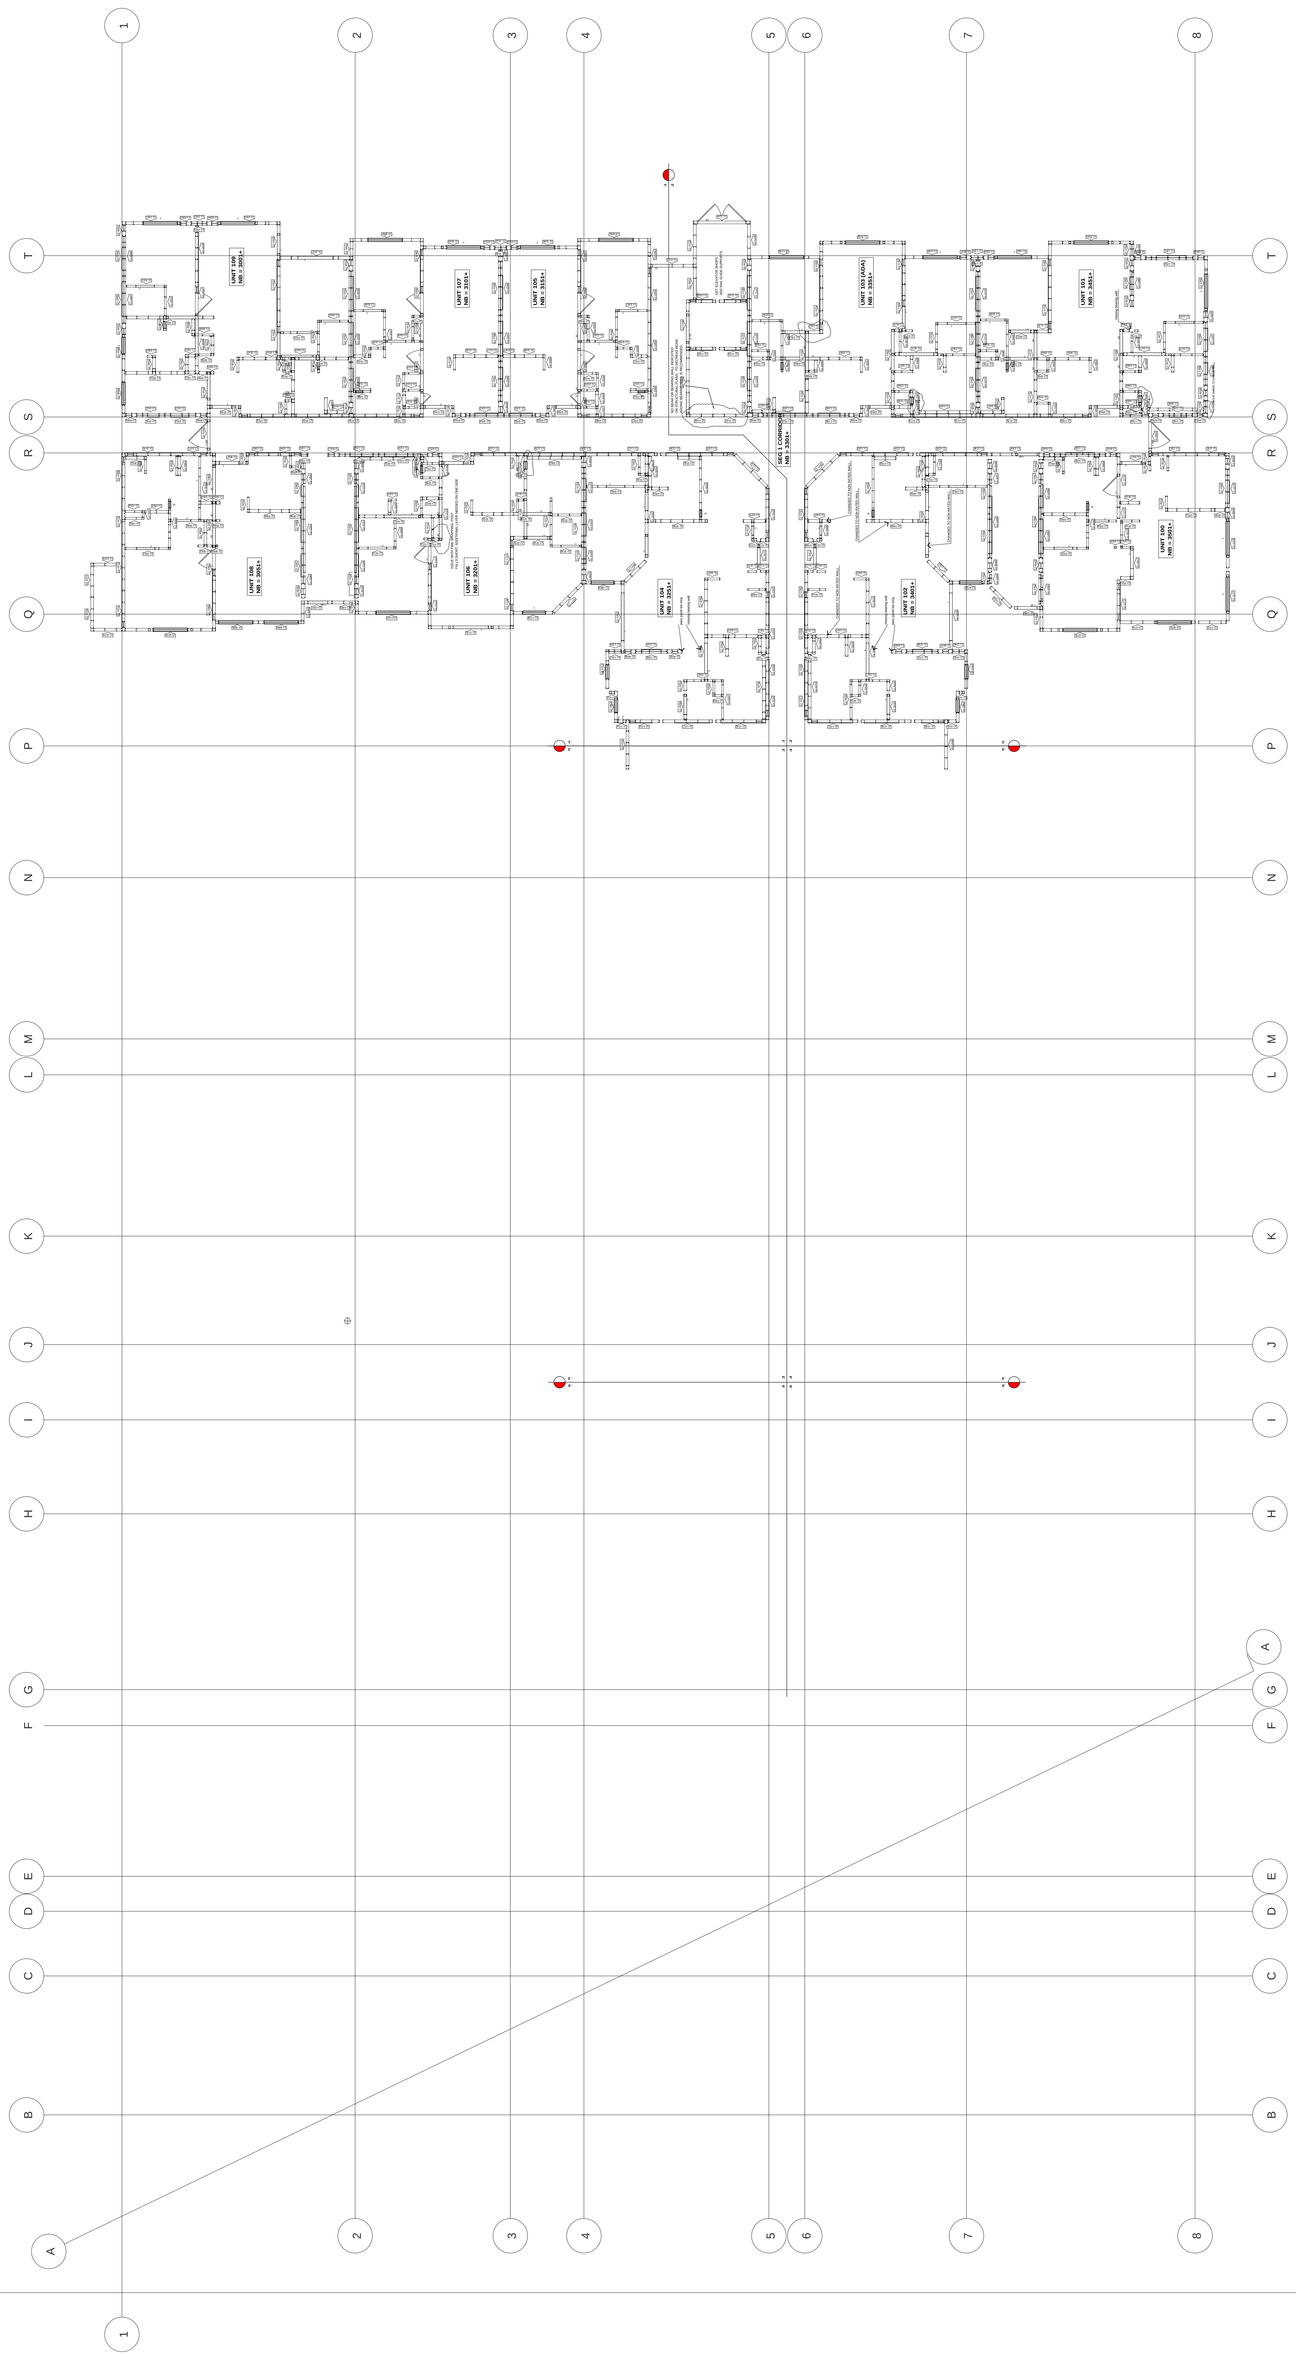

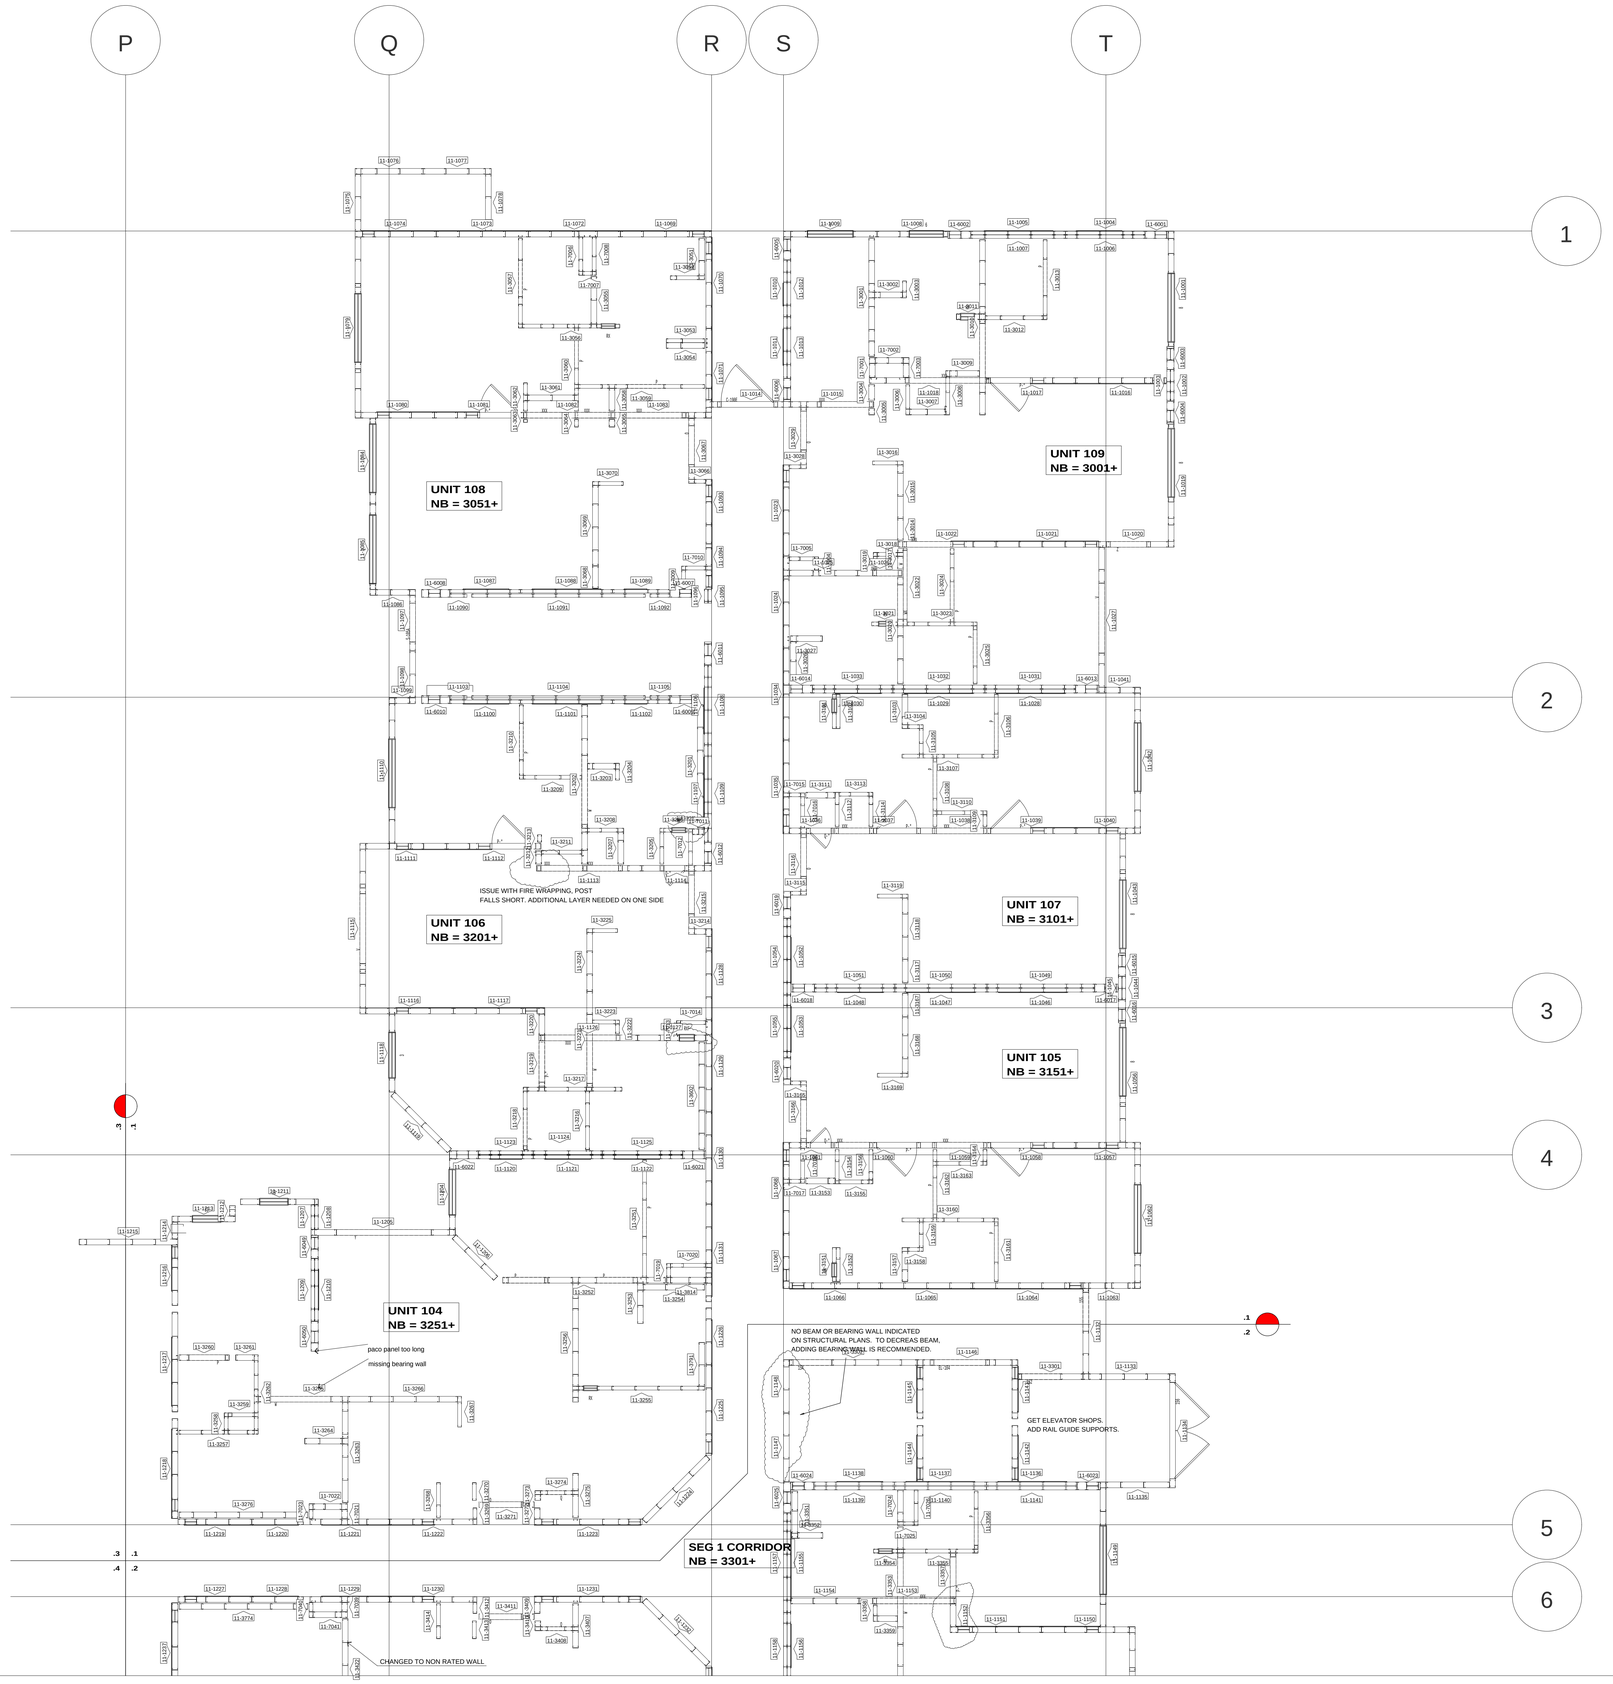

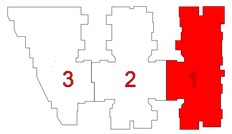

REV.	DATE	DESCRIPTION
1	9/12	Initial
-	-	-
-	-	-
-	-	-
-	-	-
-	-	-
-	-	-
-	-	-
-	-	-
-	-	-

DRAWING STATUS	DATE
SUBMITTAL	-
REDLINE COMPLETION	-
APPROVED	-
X ISSUED FOR FABRICATION	9/12/08

Wall Panel Layout (Segment 1a)

Jewish Home for the Aging

1885 Victory Blvd.
Resedta, CA

BUILDING NAME
Jewish Home for the Aging
FILE NAME
FM-07-109_JHA

FrameMax, Inc.
www.framemax.com

PROJECT NO.:
FM-07-109

DRAWING NO.:
1.2.1

PLOT DATE: 09/19/2008

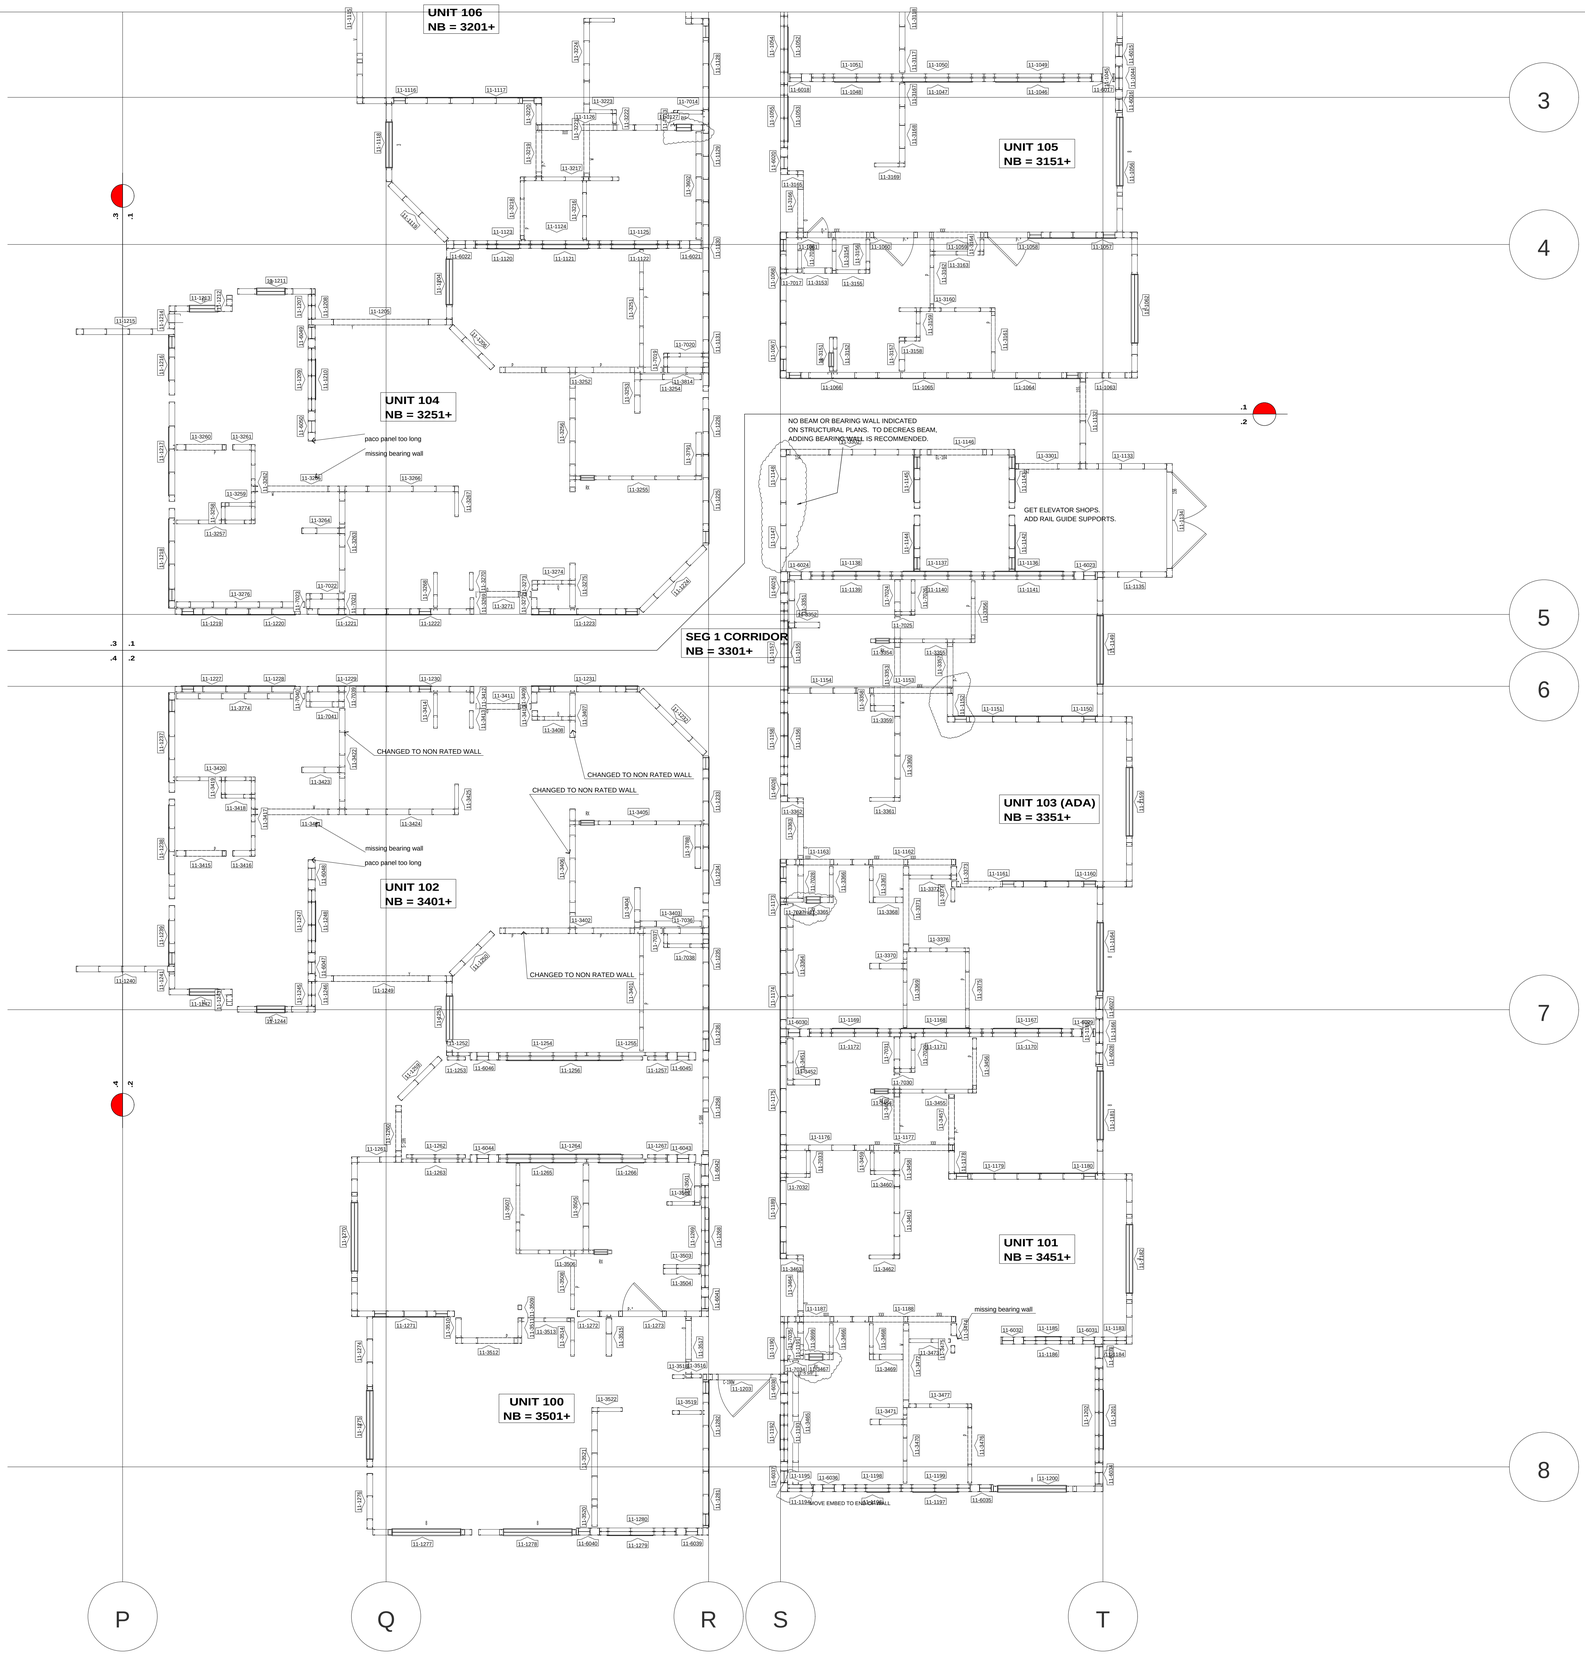

REV.	DATE	DESCRIPTION
1	9/12	Initial
.	.	.
.	.	.
.	.	.
.	.	.
.	.	.
.	.	.
.	.	.
.	.	.
.	.	.

DRAWING STATUS	DATE
SUBMITTAL	.
REDLINE COMPLETION	.
APPROVED	.
X ISSUED FOR FABRICATION	9/12/08

Wall Panel Layout (Segment 1b)

Jewish Home for the Aging

1885 Victory Blvd.
Reseda, CA

BUILDING NAME
Jewish Home for the Aging
PROJECT NAME
FM-07-109, JHA

Framemax, Inc.
11845 Sorrento St. S 100
Poway, CA 92064
T: 858.679.7000
F: 858.488.7220
www.framemax.com

PROJECT NO.:
FM-07-109

DRAWING NO.:
1.2.2

PLOT DATE: 09/19/2008