REV.	DATE	DESCRIPTION
1	11/07	HH
-	-	-
-	-	-
-	-	-
-	-	-
-	-	-
-	-	-
-	-	-
-	-	-

DRAWING STATUS	DATE
☐ SUBMITTAL	-
☐ REVIEW COMPLETION	-
☐ APPROVED	-
☐ ISSUED FOR FABRICATION	-

DRAWING TITLE

Level 2 Wall Layout Overall

Jewish Home for the Aging

1885 Victory Blvd.
Reseda, CA

RAMEMAX

BUILDING NAME
Jewish Home for the Aging
PROJECT
FM-07-109, JHA

Framemax, Inc.
13915 Dalewalton St. S 100
Poway, CA 92064
P: 858.486.7200
F: 858.486.7220
www.framemax.com

PROJECT NO.
FM-07-109

DRAWING NO.
2.2.0

PLOT DATE 11/20/2008

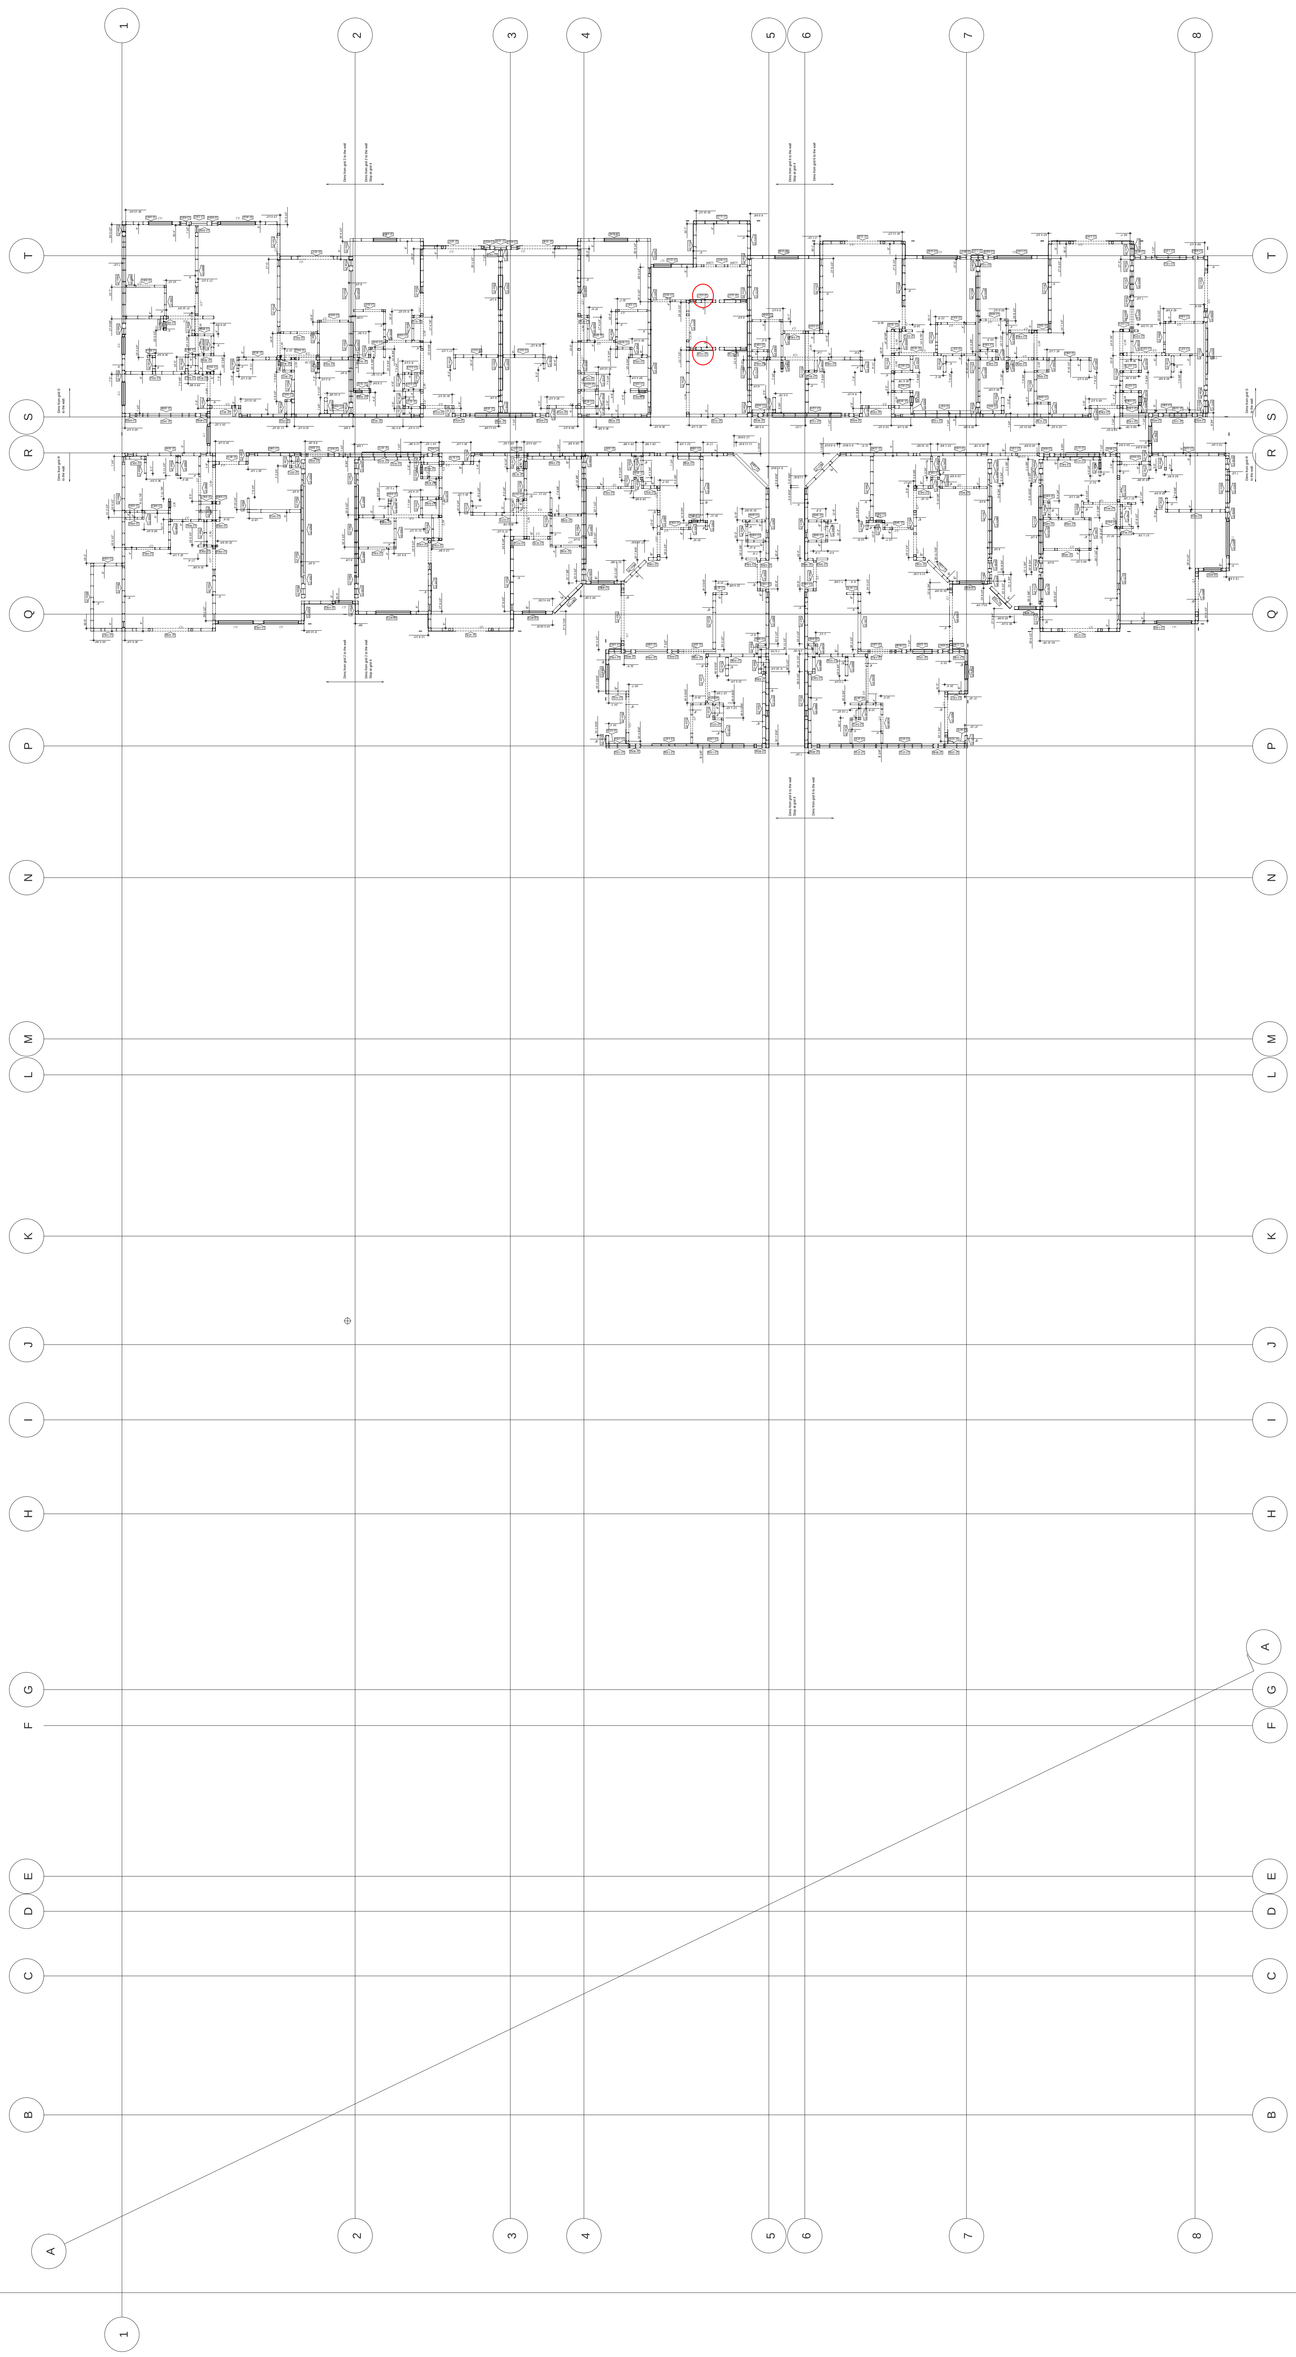

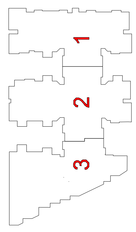

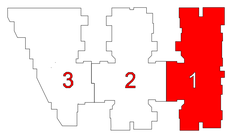

REV.	DATE	DESCRIPTION
1	11/07	HH
.	.	.
.	.	.
.	.	.
.	.	.
.	.	.
.	.	.
.	.	.
.	.	.
.	.	.

DRAWING STATUS	DATE
SUBMITTAL	.
REDLINE COMPLETION	.
APPROVED	.
ISSUED FOR FABRICATION	.

Level 2 Wall Layout (Segment 1a)

Jewish Home for the Aging

1885 Victory Blvd.
Resedta, CA

PRAMEMAX

Framemax, Inc.
Poway, CA 92064
T: 858-486-7220
F: 858-486-7220
www.framemax.com

PROJECT NO.:
FM-07-109

DRAWING NO.:
2.2.1

PLOT DATE: 11/19/2008

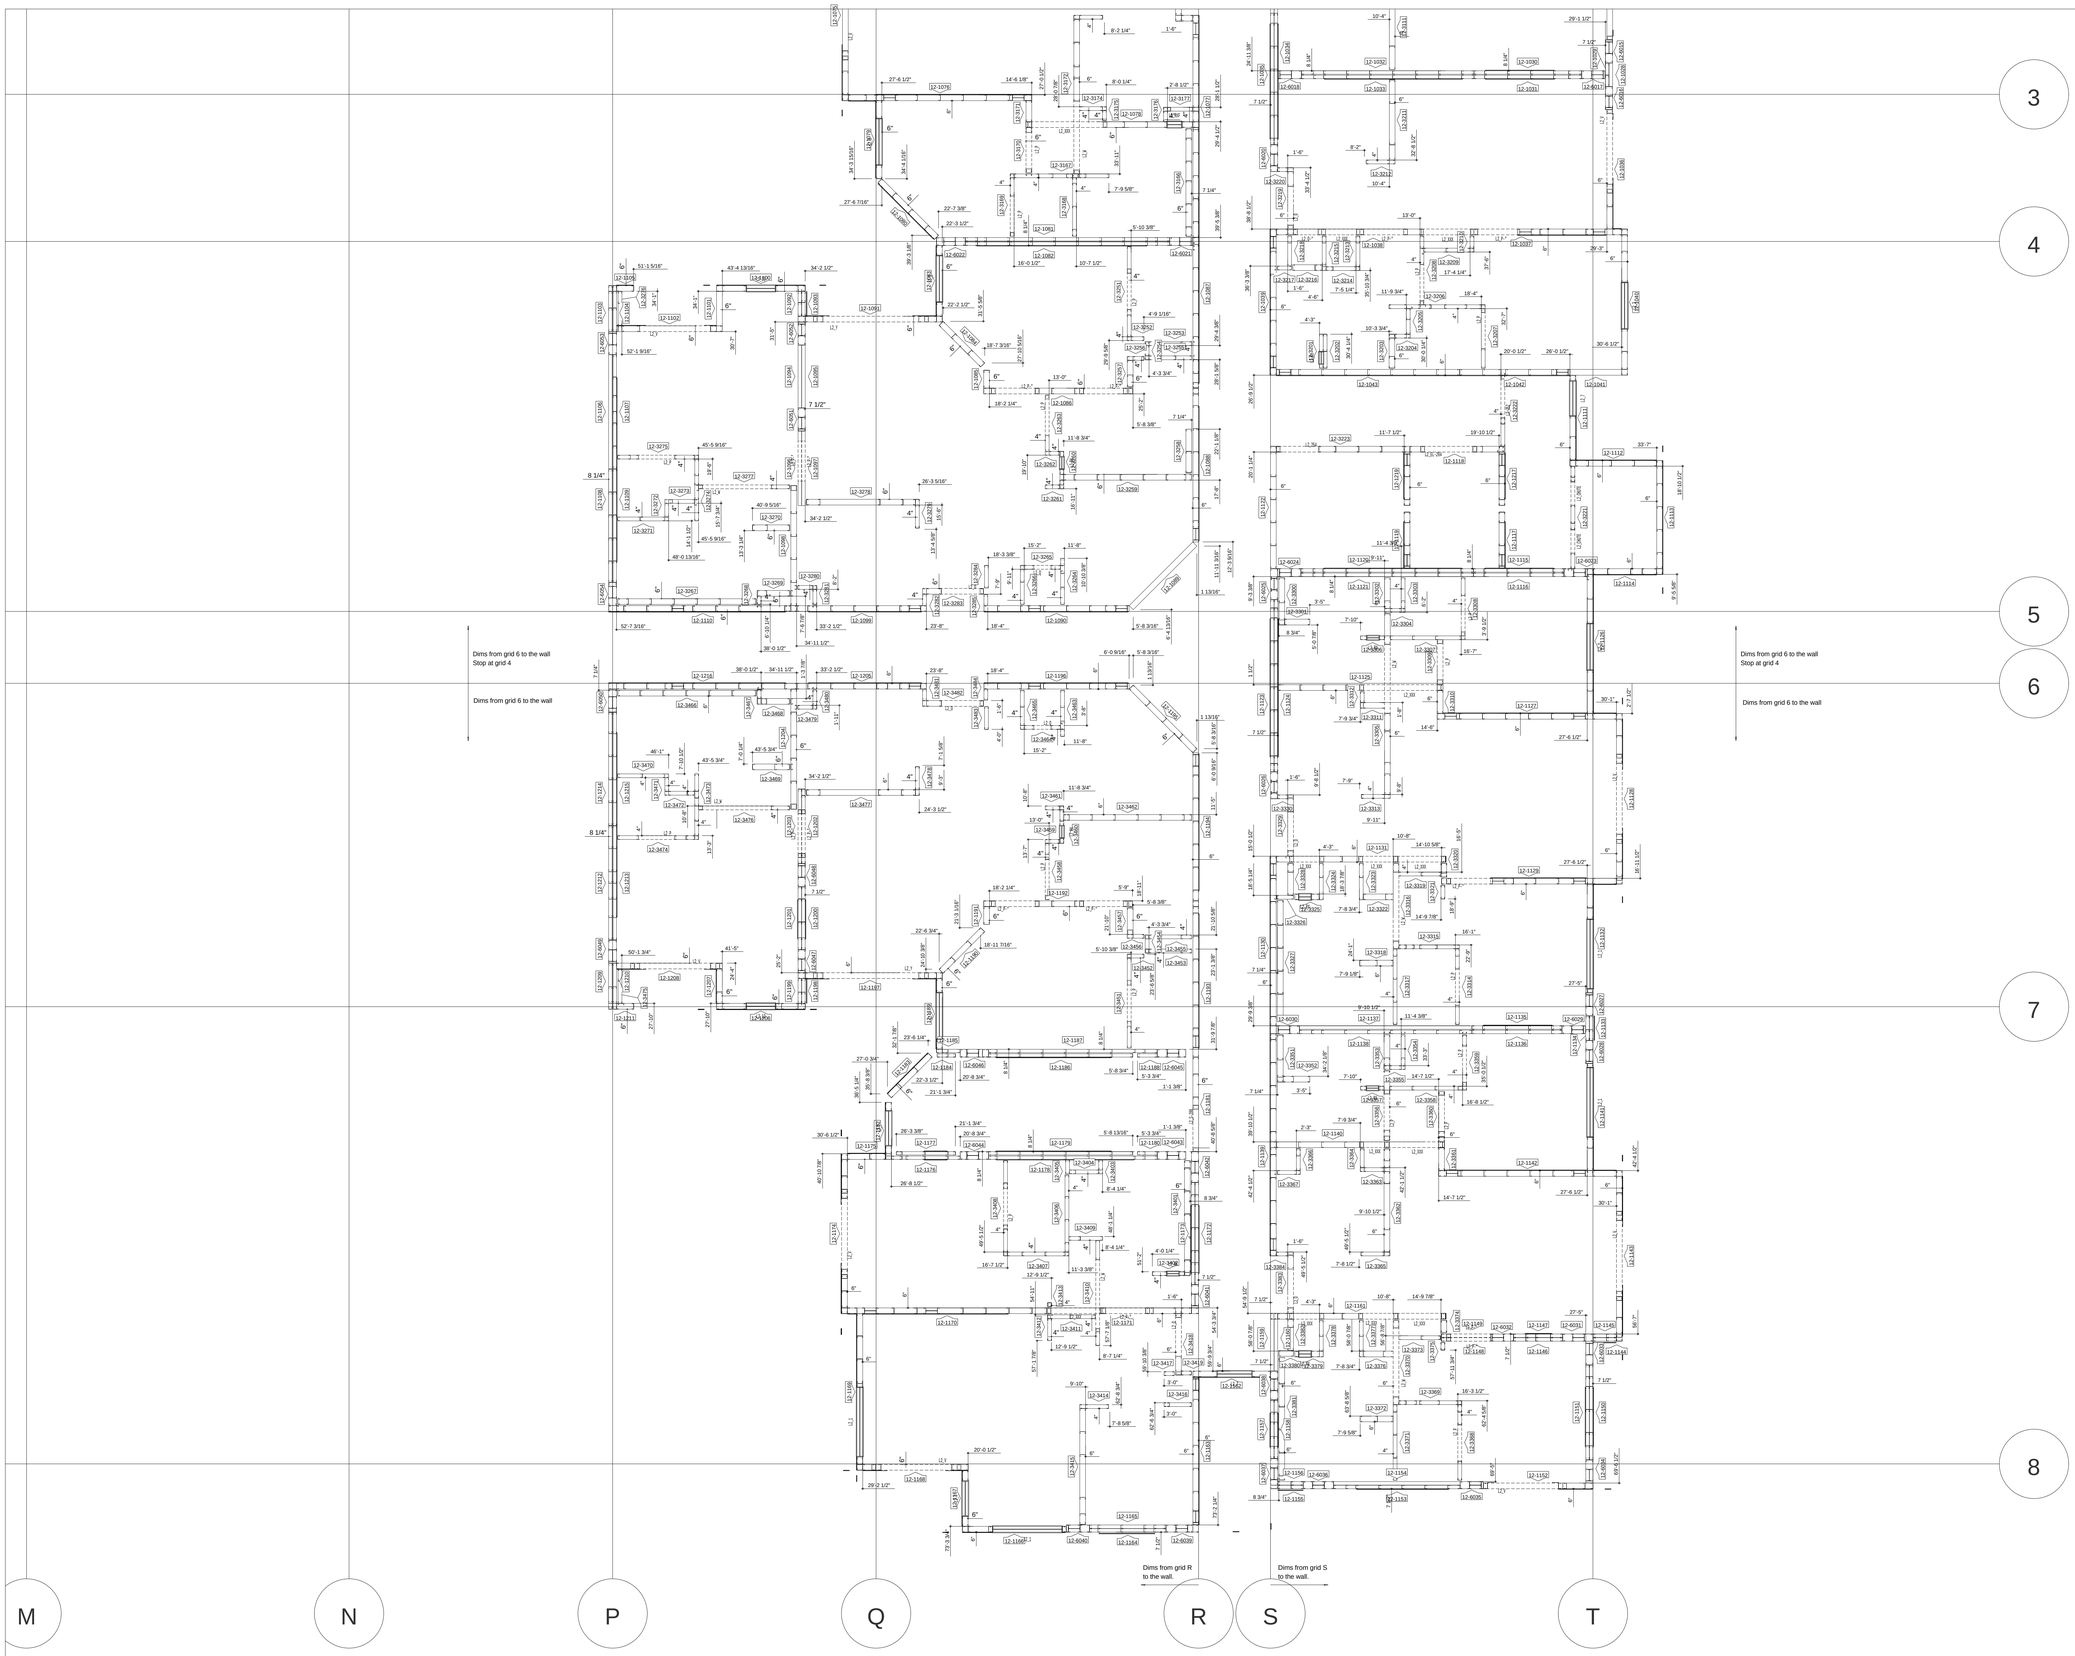

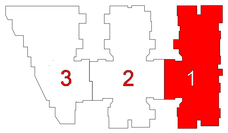

REV.	DATE	DESCRIPTION
1	11/07	HH
.	.	.
.	.	.
.	.	.
.	.	.
.	.	.
.	.	.
.	.	.
.	.	.
.	.	.

DRAWING STATUS	DATE
SUBMITTAL	.
REDLINE COMPLETION	.
APPROVED	.
ISSUED FOR FABRICATION	.

DRAWING TITLE

Level 2 Wall Layout (Segment 1b)

Jewish Home for the Aging

1885 Victory Blvd.
Reseda, CA

BUILDING NAME
Jewish Home for the Aging
PROJECT NAME
FM07 - 109, JHA

Framemax Inc.
www.framemax.com

FRAMEMAX

PROJECT NO.:
FM-07-109

DRAWING NO.:
2.2.2

PLOT DATE 11/19/2008