REV.	DATE	DESCRIPTION
1	11/07	HH
-	-	-
-	-	-
-	-	-
-	-	-
-	-	-
-	-	-
-	-	-
-	-	-

DRAWING STATUS — DATE

- ☐ SUBMITTAL — -
- ☐ REVIEW COMPLETION — -
- ☐ APPROVED — -
- ☐ ISSUED FOR FABRICATION — -

Jewish Home for the Aging

1885 Victory Blvd.
Reseda, CA

Level 2 Wall Layout Overall

DRAWING TITLE

RAMEMAX
BUILDING NAME
Jewish Home for the Aging
PROJECT
FM-07-109, JHA
Framemax, Inc.
13915 Dalewalton St. S 100
Poway, CA 92064
P: 858.486.7200
F: 858.486.7220
www.framemax.com

PROJECT NO. FM-07-109

DRAWING NO. **2.2.0**

PLOT DATE 12/11/2008

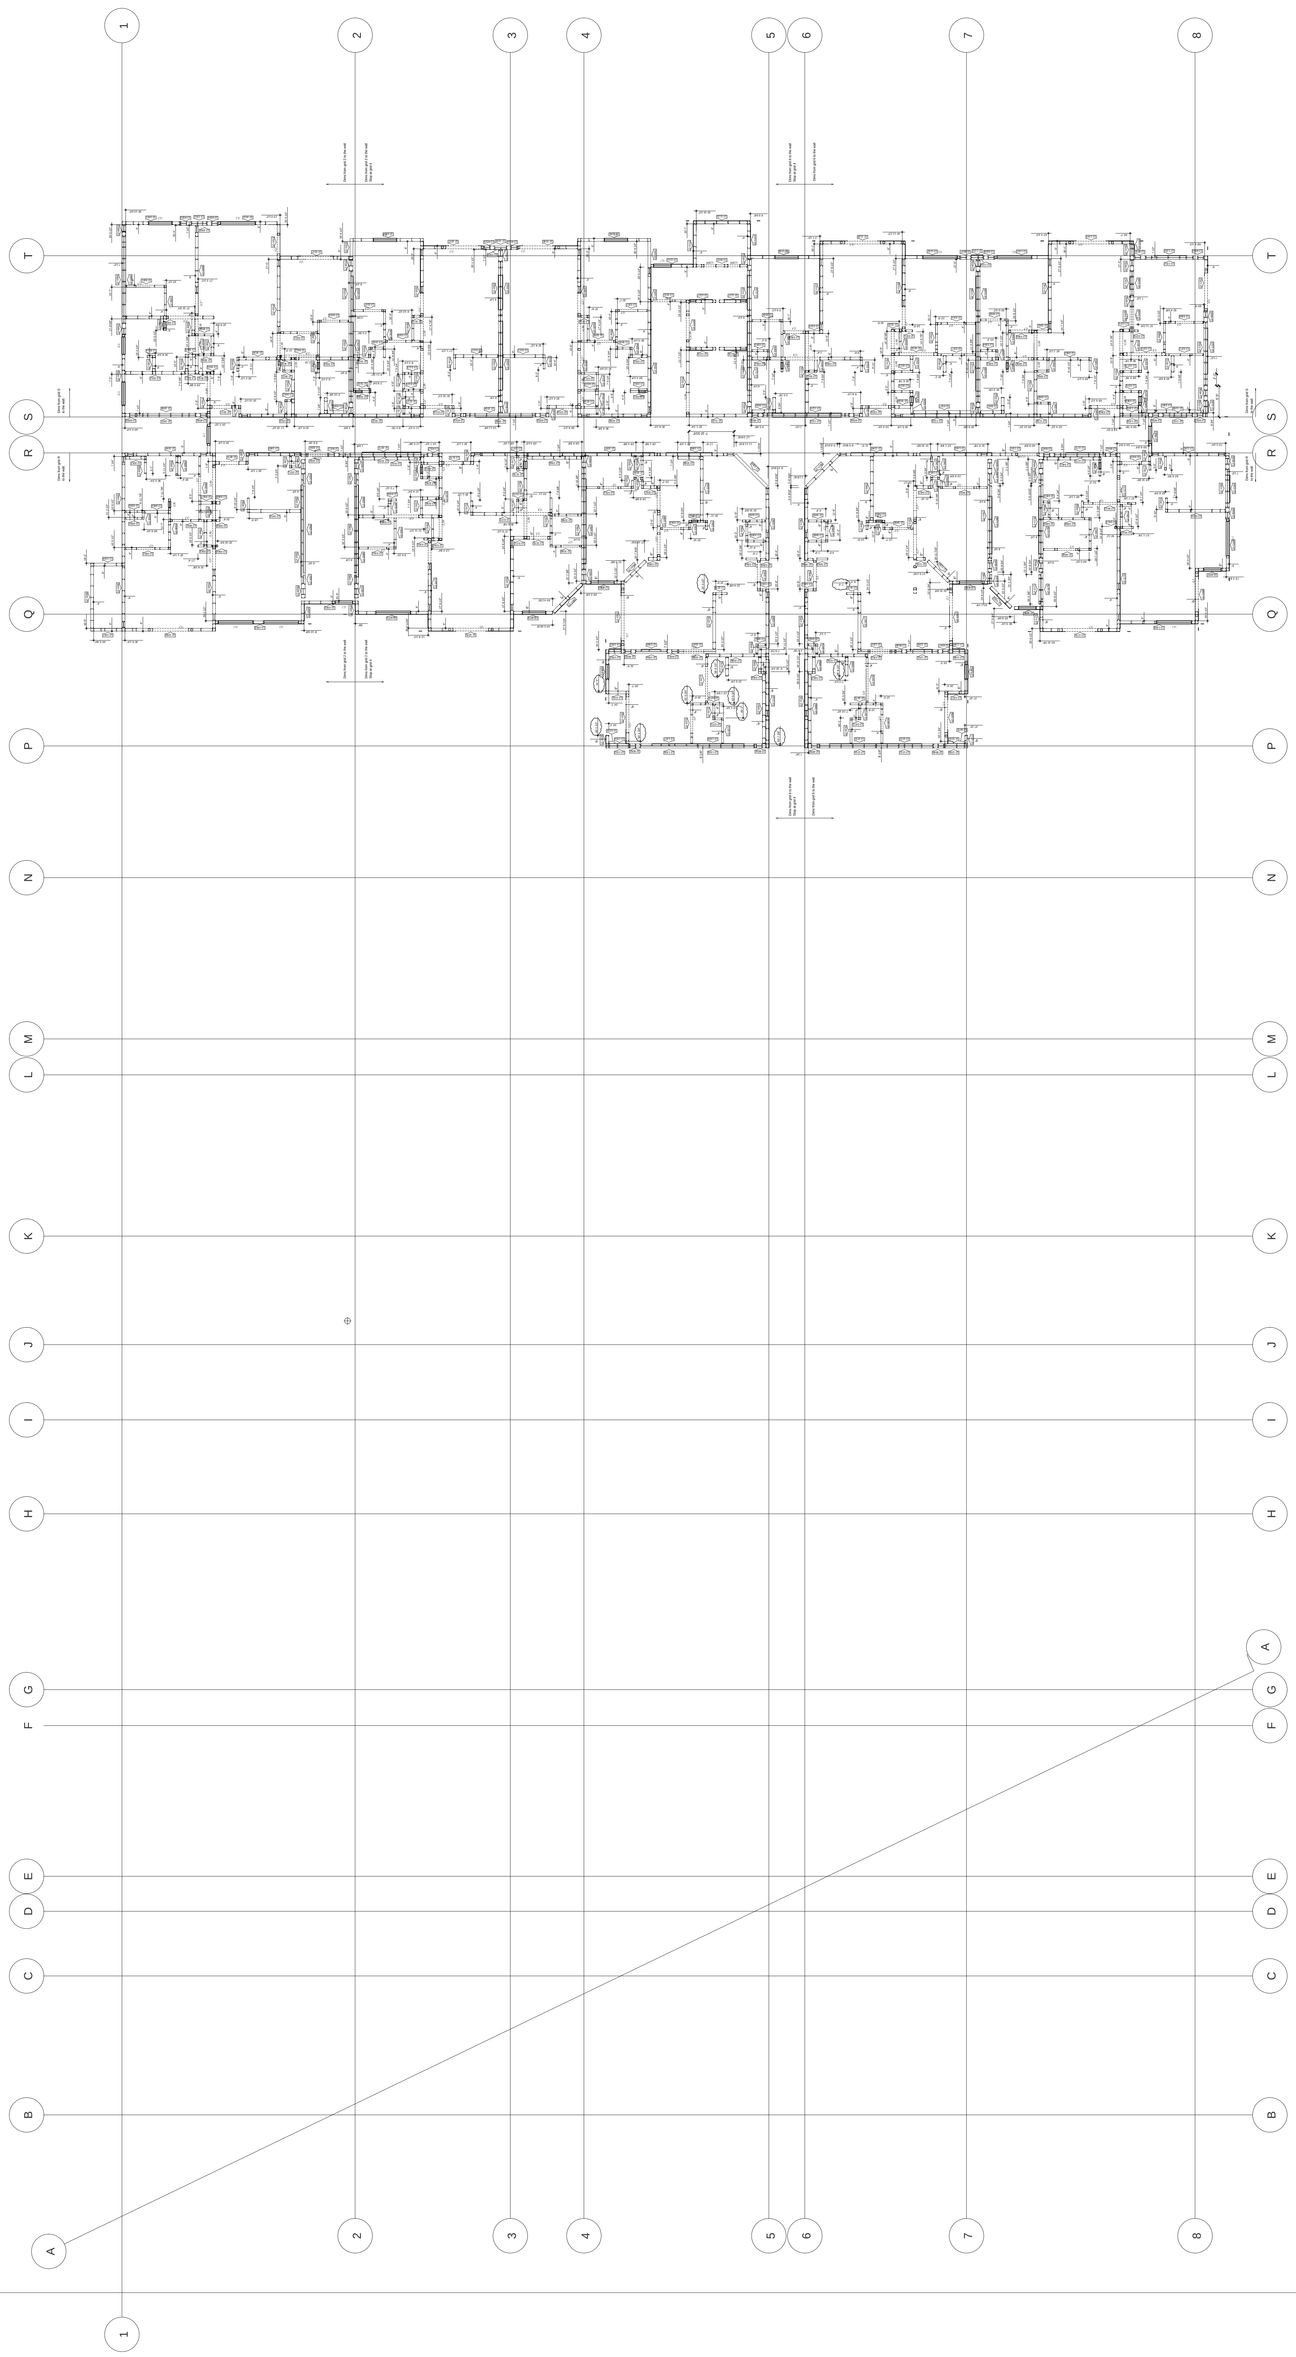

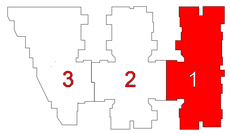

REV.	DATE	DESCRIPTION
1	11/07	HH
.	.	.
.	.	.
.	.	.
.	.	.
.	.	.
.	.	.
.	.	.
.	.	.
.	.	.

DRAWING STATUS	DATE
SUBMITTAL	.
REDLINE COMPLETION	.
APPROVED	.
ISSUED FOR FABRICATION	.

Level 2 Wall Layout (Segment 1a)

Jewish Home for the Aging

1885 Victory Blvd.
Reseda, CA

PRELIMINARY

AS PER: MAR
Jewish Home for the Aging
1885 Victory Blvd.
Reseda, CA
FM-07-109, JHA

Frame Max, Inc.
T: 858-486-7220
F: 858-486-7220
www.framemax.com

FRAMEMAX

PROJECT NO.:
FM-07-109

DRAWING NO.:
2.2.1

PLOT DATE: 12/11/2008

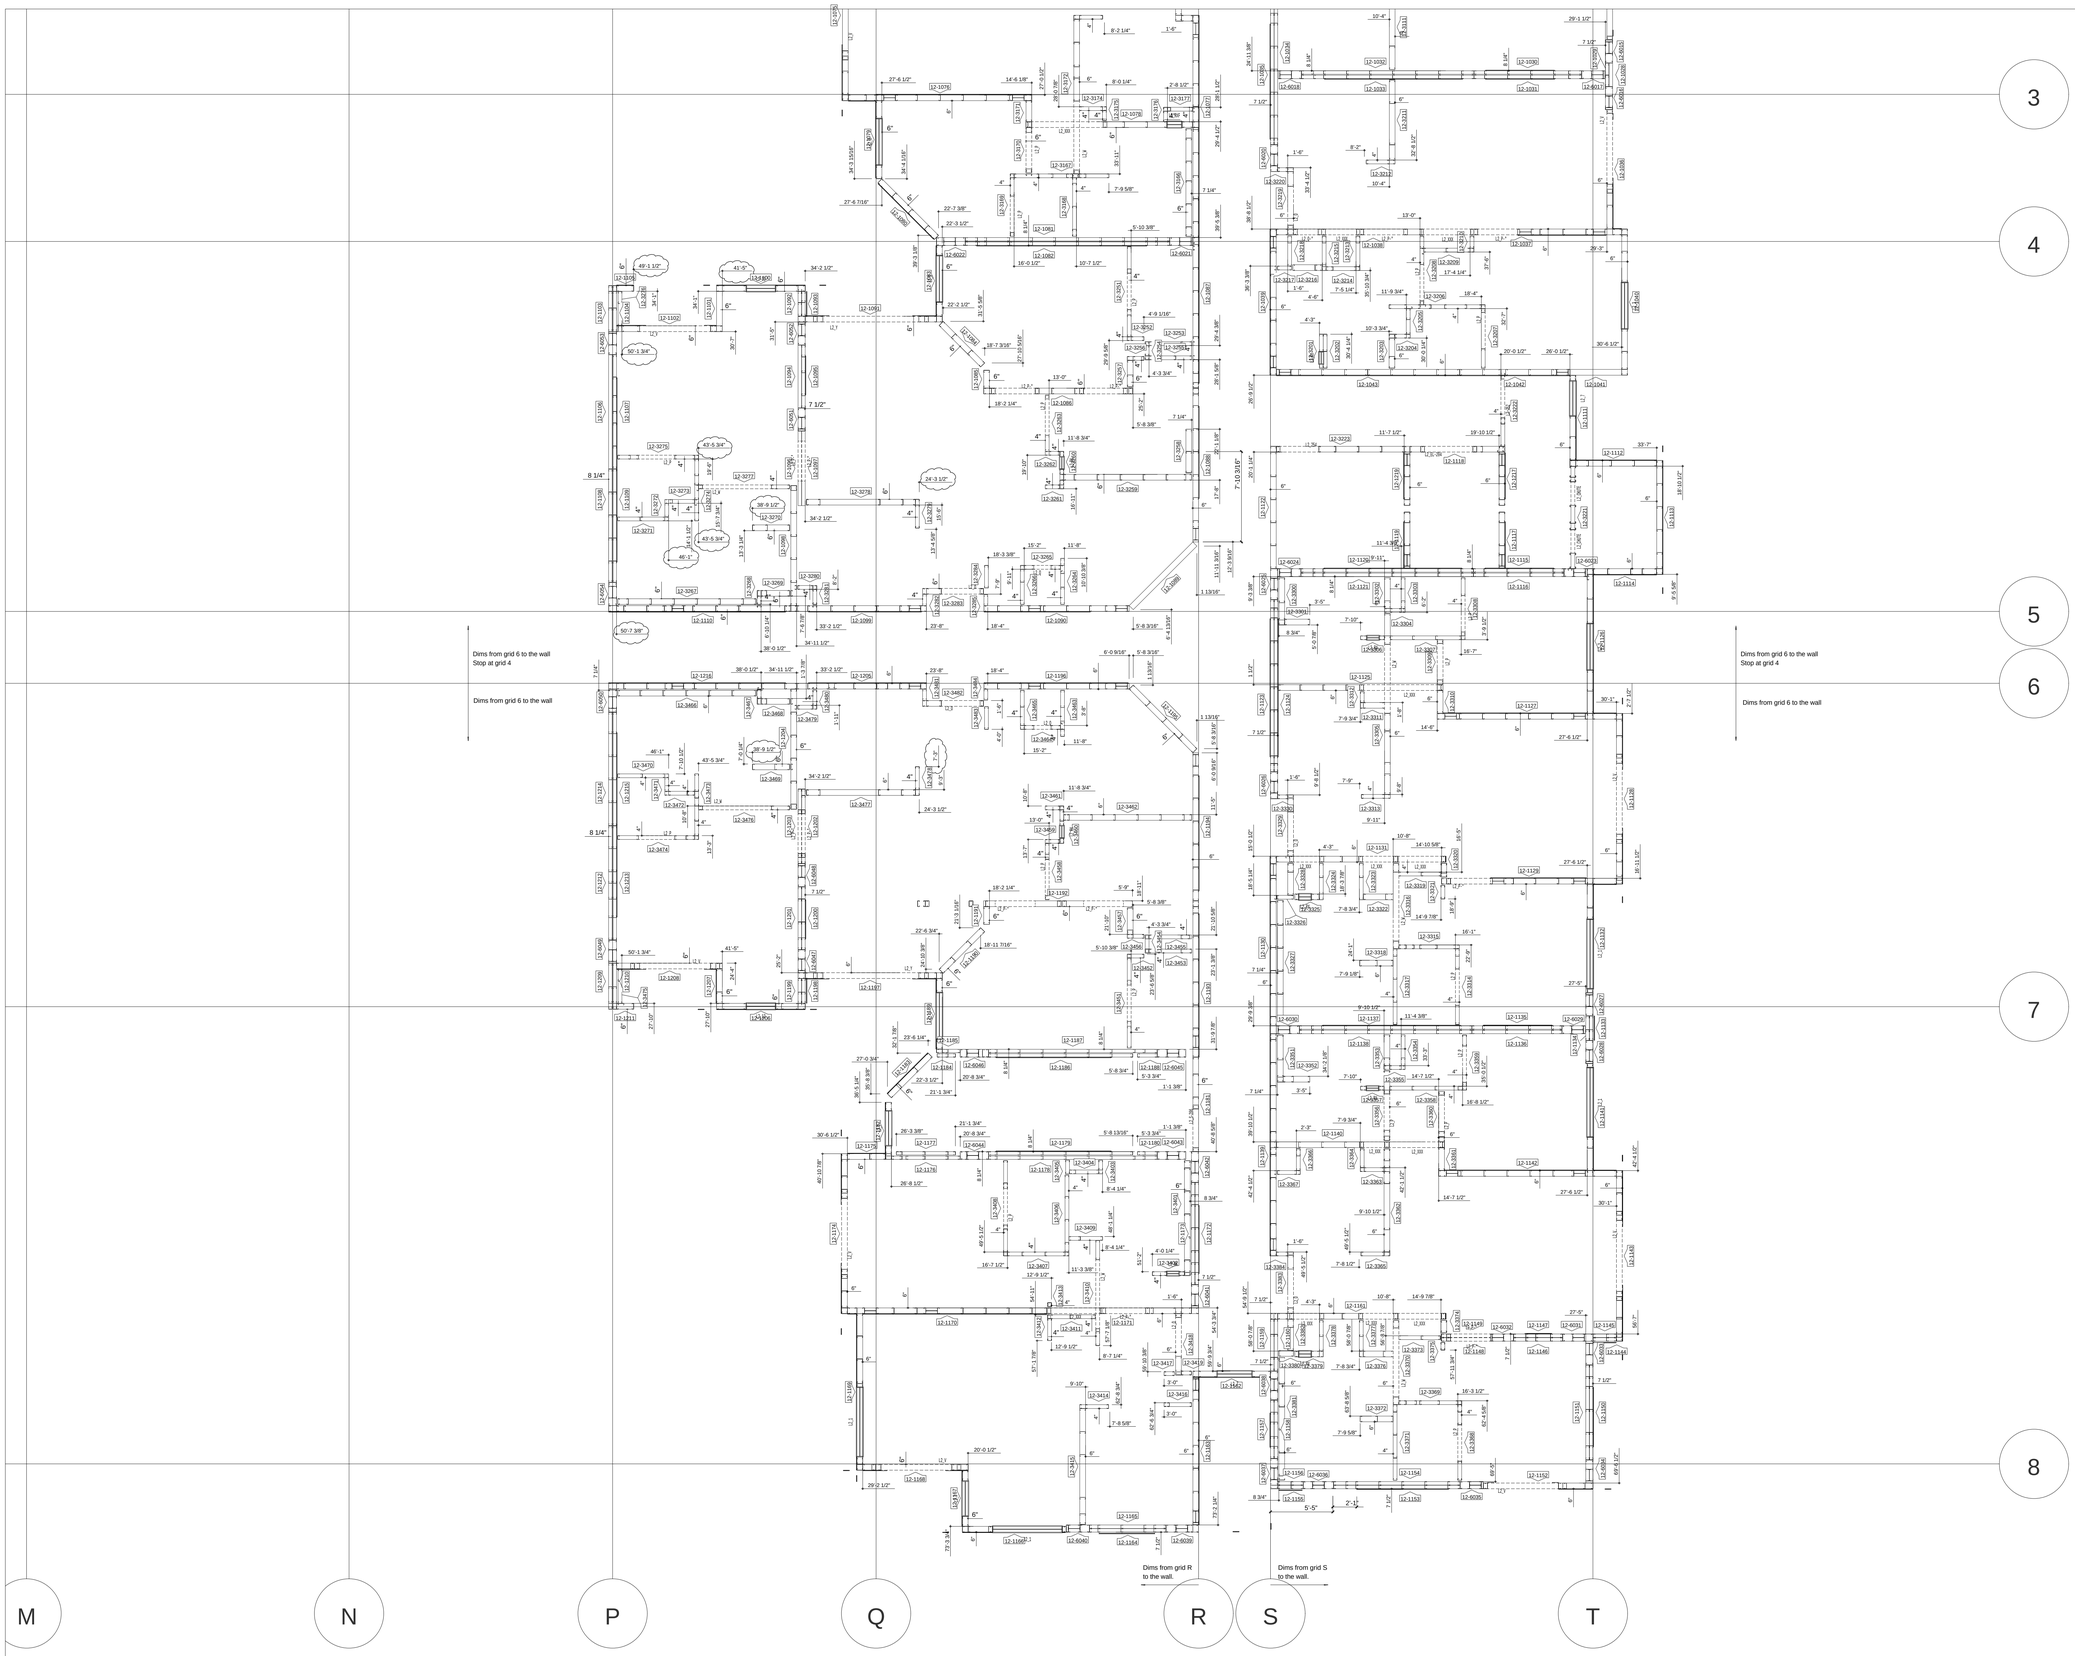

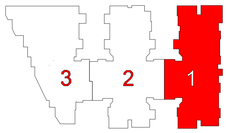

REV.	DATE	DESCRIPTION
1	11/07	HH
.	.	.
.	.	.
.	.	.
.	.	.
.	.	.
.	.	.
.	.	.
.	.	.
.	.	.

DRAWING STATUS	DATE
SUBMITTAL	.
REDLINE COMPLETION	.
APPROVED	.
ISSUED FOR FABRICATION	.

DRAWING TITLE

Level 2 Wall Layout (Segment 1b)

Jewish Home for the Aging

1885 Victory Blvd.
Reseda, CA

BUILDING NAME
Jewish Home for the Aging
PROJECT NAME
FM-07-109

Framemax Inc.
Poway, CA 92064
P: 858.486.7000
F: 858.486.7220
www.framemax.com

FRAMEMAX

PROJECT NO.:
FM-07-109

DRAWING NO.:
2.2.2

PLOT DATE 12/11/2008